






Metres 20 40 60 80 100



NOTES

The Contractor is to check all dimensions and conditions on site before commencing. Do not scale from this drawing.
This drawing remains the copyright of POZZONI LLP.

-  Line of existing footpath
-  Section of footpath to be closed
-  Line of diverted footpath
-  Waymarker sign

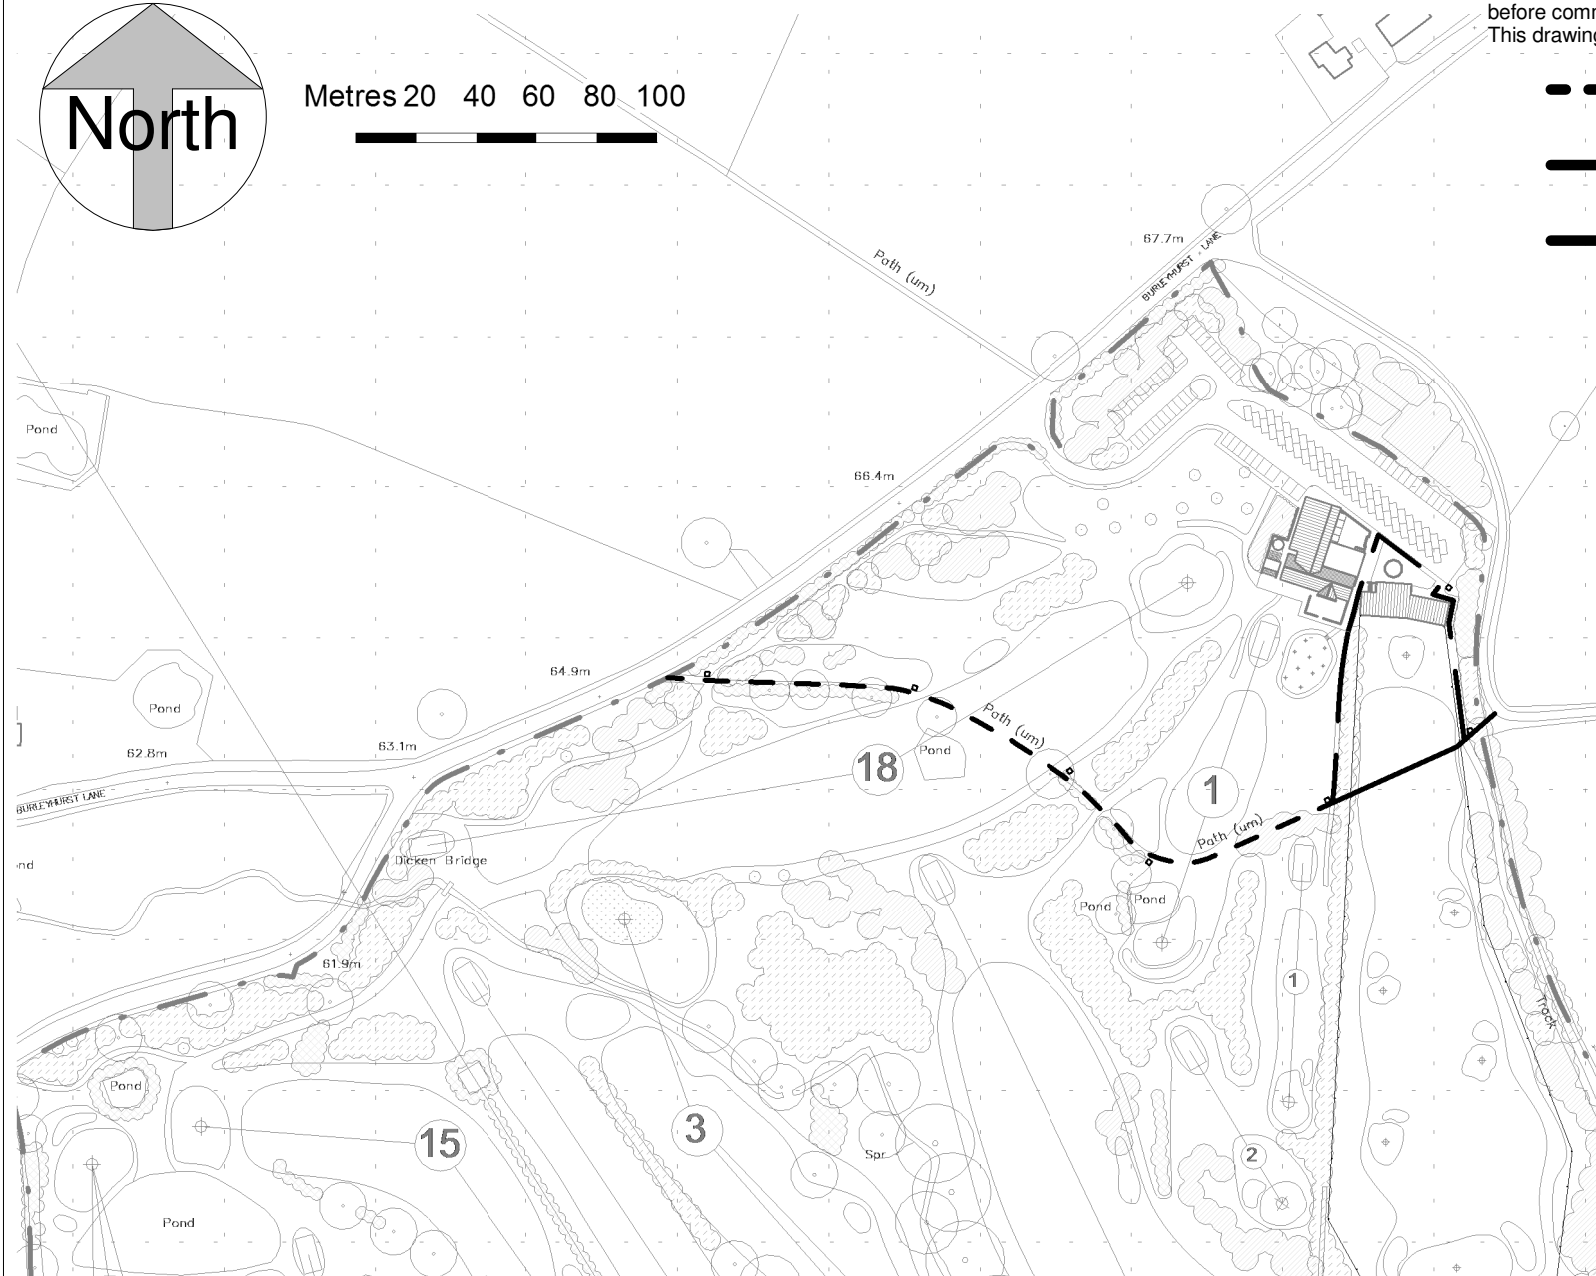

Drawing

Town and Country Planning
Act 1990 - Section 257 -
Proposed Diversion of
Footpath (Reference.
Mobberley FP 55)

- ☐ Feasibility
- ☒ Design
- ☐ Tender
- ☐ Contract
- ☐ Construction
- ☐ As Built

Scale	1 : 2500	@ A4
Drawn	JW	
Date	Sept 2010	Rev
Drg. No.	P2701	910