


There are Mains layers switched off. There may be gas mains in this area that you cannot see.

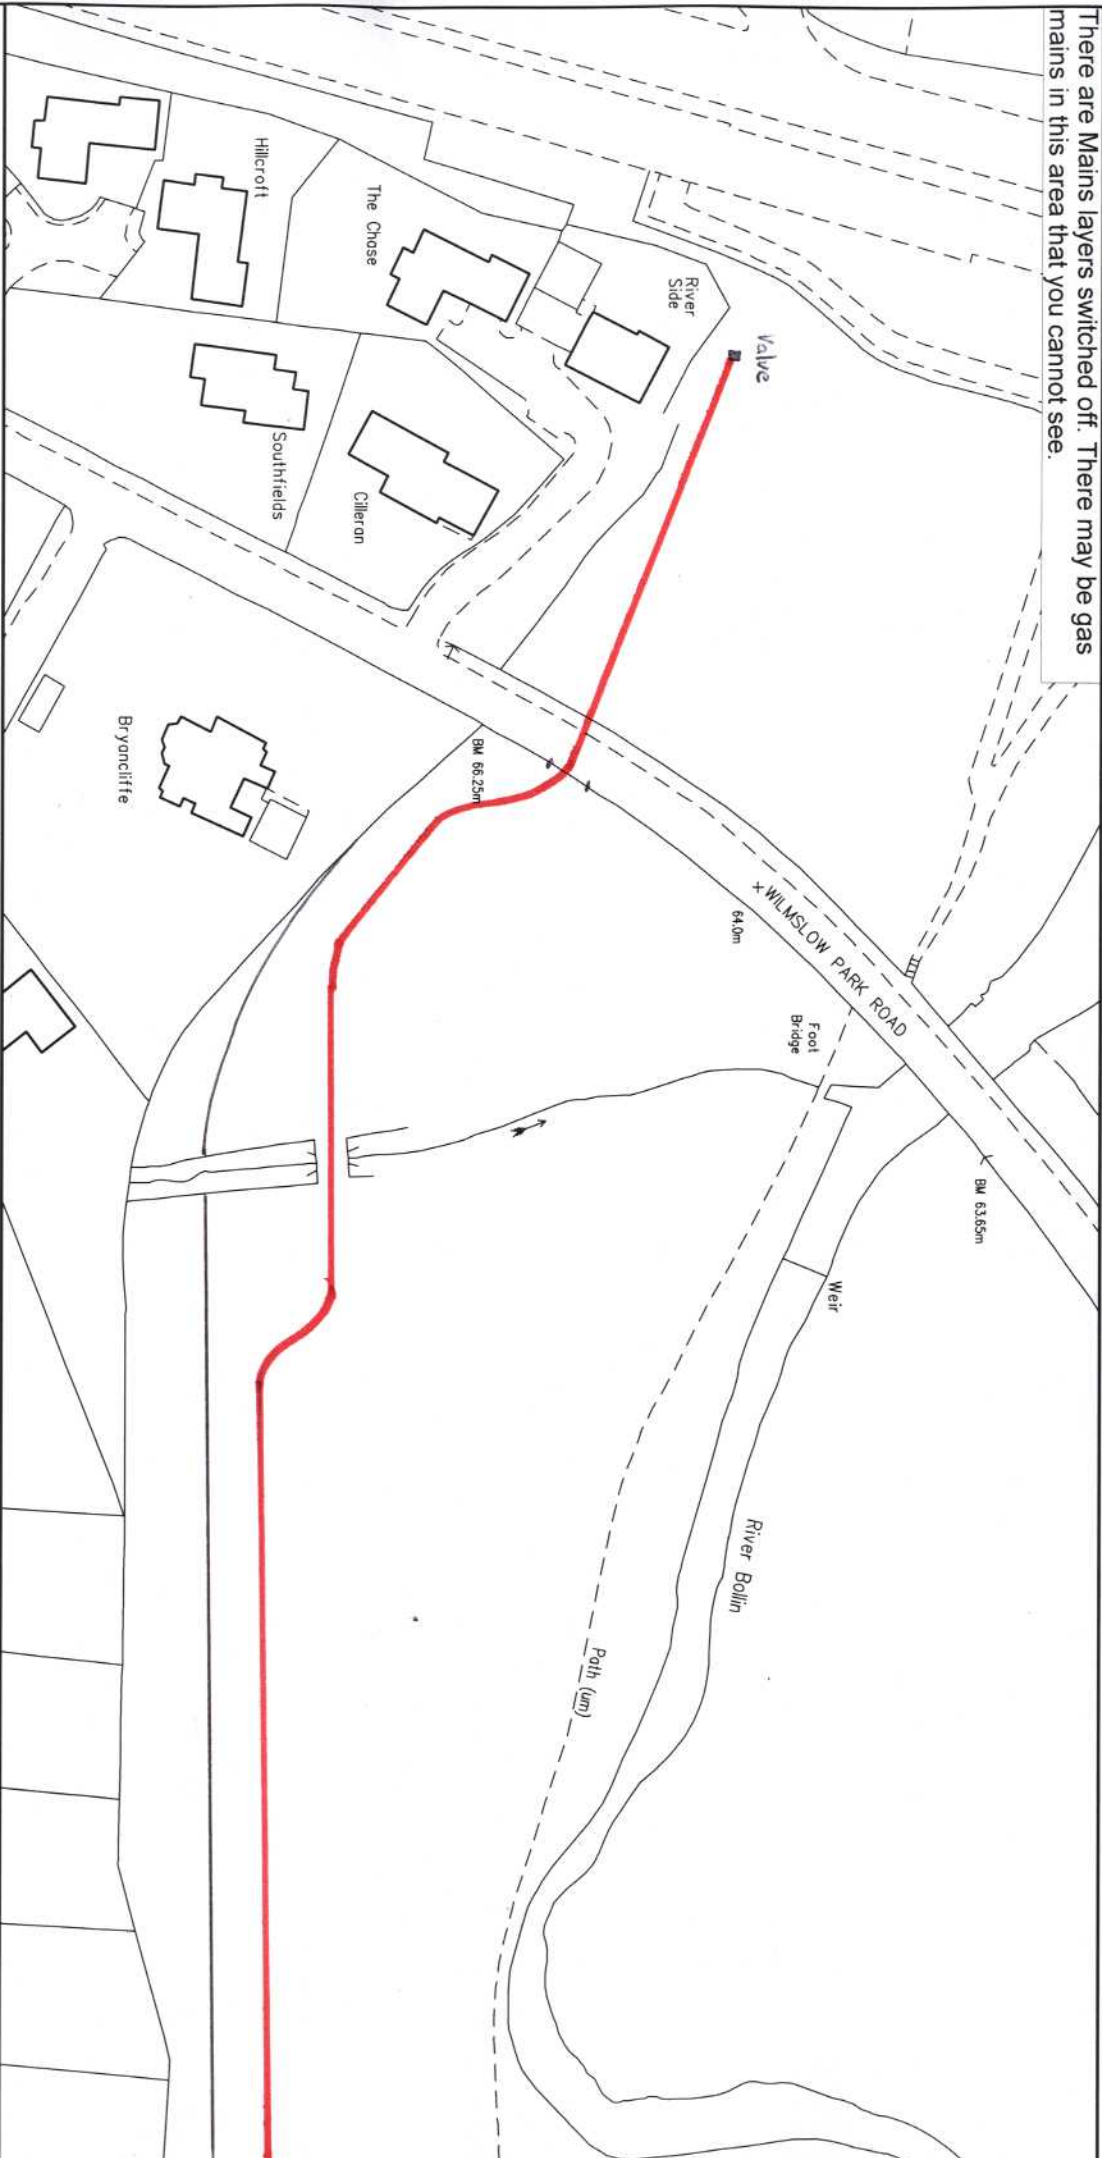

Warning: ALL AS-LAID MAINS LAYERS MAY NOT BE SHOWN

SCALE: Not to scale	
USER ID: james.dean	LP MAINS
DATE: 06/05/2010	IP MAINS
INTERNAL USE ONLY	LHP MAINS
MAP REF: SJ8581	NHP MAINS
CENTRE: 385296, 381186	HISTORY MAINS
Some examples of Plant Items:	
Valve	Depth of Cover
Syphon	Diameter Change
Material Change	


This plan shows those pipes owned by National Grid Gas plc in their role as a Licensed Gas Transporter (GT). Gas pipes owned by other GTs, or otherwise privately owned, may be present in this area. Information with regard to such pipes should be obtained from the relevant owners. The information shown on this plan is given without warranty, the accuracy thereof cannot be guaranteed. Service pipes, valves, syphons, stub connections, etc. are not shown but their presence should be anticipated. No liability of any kind whatsoever is accepted by National Grid Gas plc or their agents, servants or contractors for any error or omission. Safe digging practices, in accordance with HS(G)47, must be used to verify and establish the actual position of mains, pipes, services and other apparatus on site before any mechanical plant is used. It is your responsibility to ensure that this information is provided to all persons (either direct labour or contractors) working for you on or near gas apparatus. The information included on this plan should not be referred to beyond a period of 28 days from the date of issue.

Desktop MAPS Version 5.1.2.0

Hinckley Server

This plan is reproduced from or based on the OS map by National Grid Gas plc, with the sanction of the controller of HM Stationery Office. Crown Copyright Reserved.

There are Mains layers switched off. There may be gas mains in this area that you cannot see.

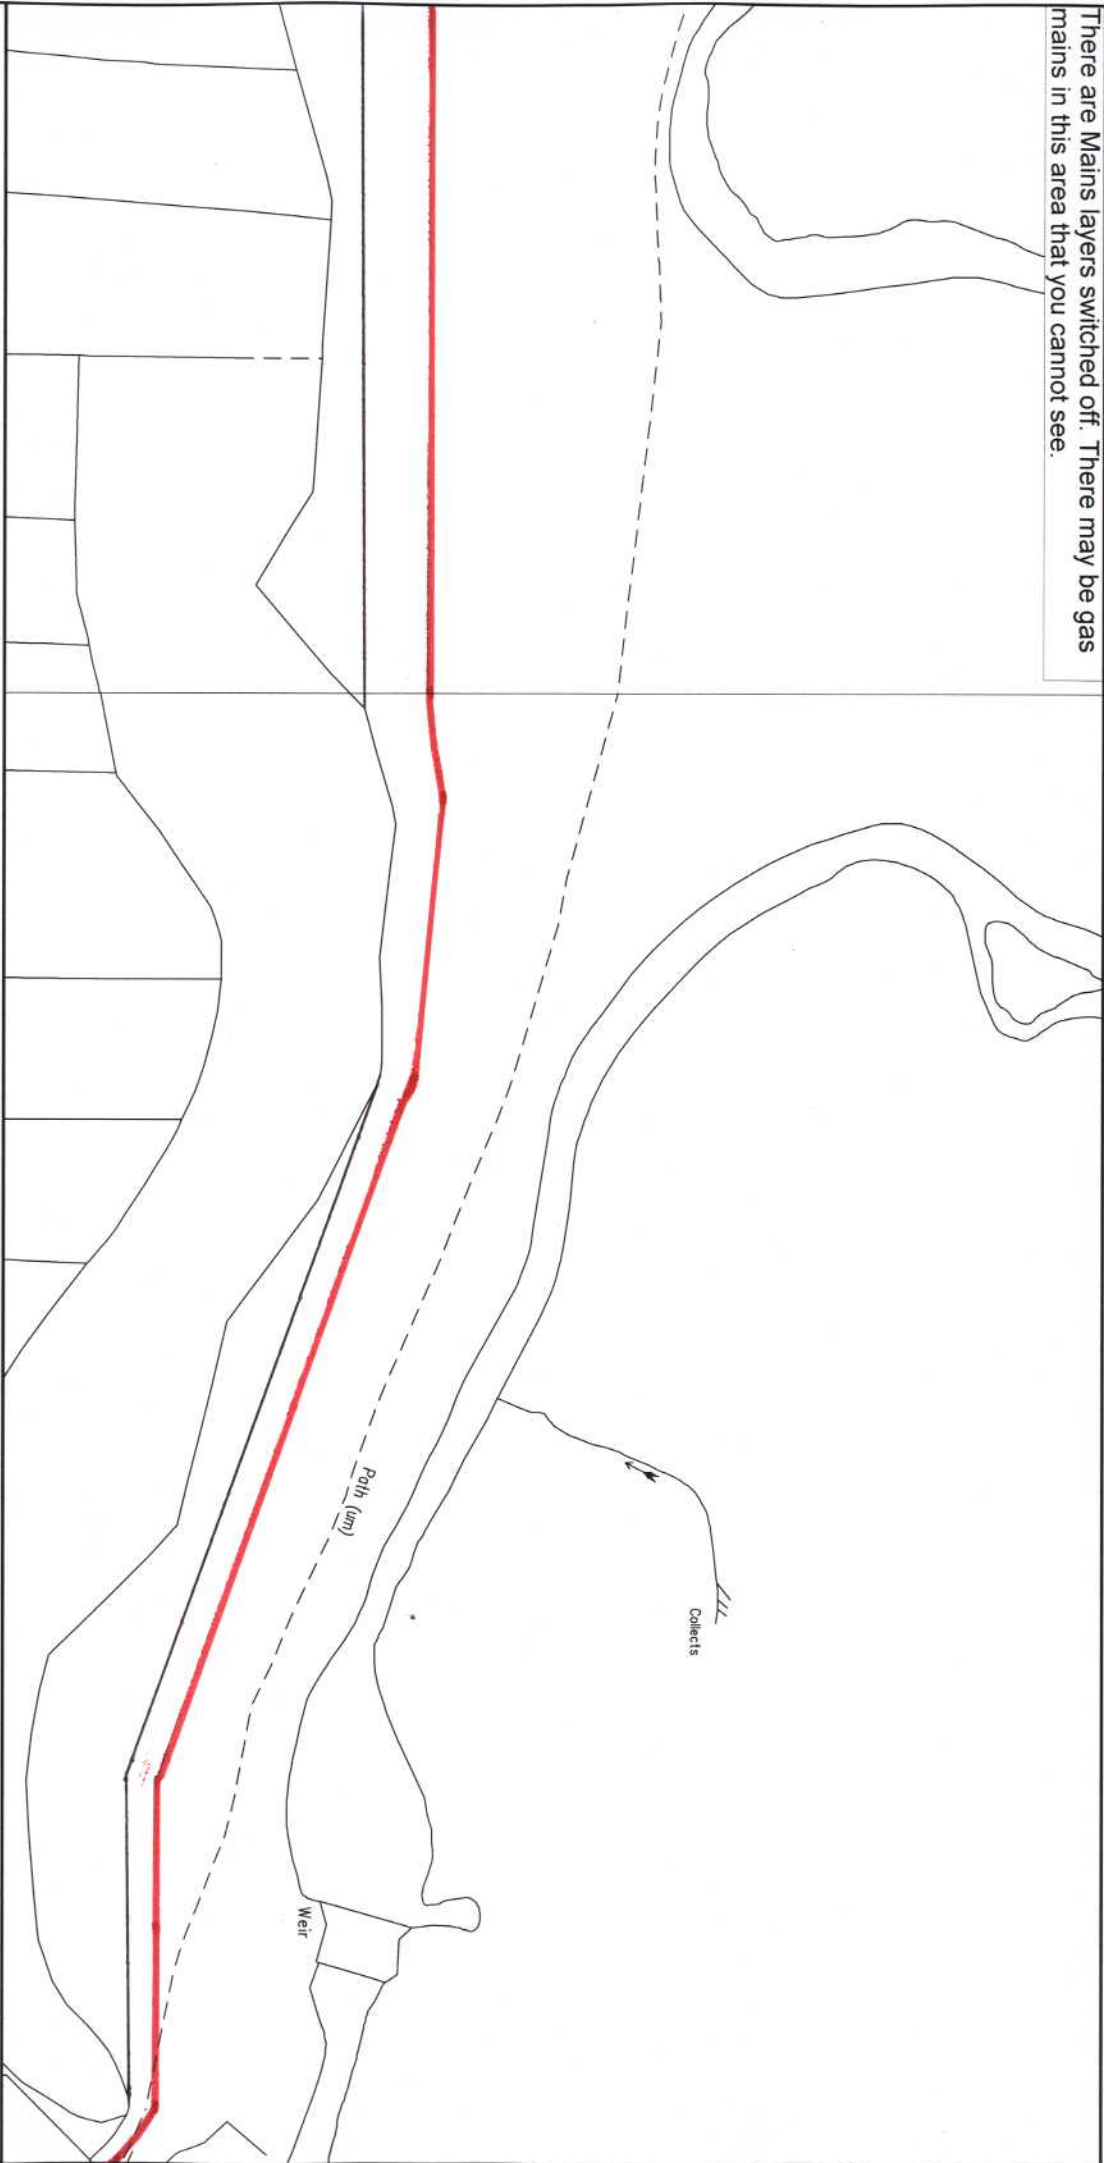

Warning: ALL AS-LAID MAINS LAYERS MAY NOT BE SHOWN

SCALE: Not to scale	
USER ID: james.dean	
DATE: 06/05/2010	
INTERNAL USE ONLY	
MAP REF: SJ8581	
CENTRE: 385554, 381165	
Some examples of Plant Items: Valve Depth of Cover Syphon Diameter Change Material Change	LP MAINS MP MAINS IP MAINS LHP MAINS NHP MAINS HISTORY MAINS LAs GTs SSSIs


This plan shows those pipes owned by National Grid Gas plc in their role as a Licensed Gas Transporter (GT). Gas pipes owned by other GTs, or otherwise privately owned, may be present in this area. Information with regard to such pipes should be obtained from the relevant owners. The information shown on this plan is given without warranty, the accuracy thereof cannot be guaranteed. Service pipes, valves, syphons, stub connections, etc. are not shown but their presence should be anticipated. No liability of any kind whatsoever is accepted by National Grid Gas plc or their agents, servants or contractors for any error or omission. Safe digging practices, in accordance with HSE(G47), must be used to verify and establish the actual position of mains, pipes, services and other apparatus on site before any mechanical plant is used. It is your responsibility to ensure that this information is provided to all persons (either direct labour or contractors) working for you on or near gas apparatus. The information included on this plan should not be referred to beyond a period of 28 days from the date of issue.

Desktop MAPS Version 5.1.2.0

Hinckley Server

This plan is reproduced from or based on the OS map by National Grid Gas plc, with the sanction of the controller of HM Stationery Office. Crown Copyright Reserved.

There are Mains layers switched off. There may be gas mains in this area that you cannot see.

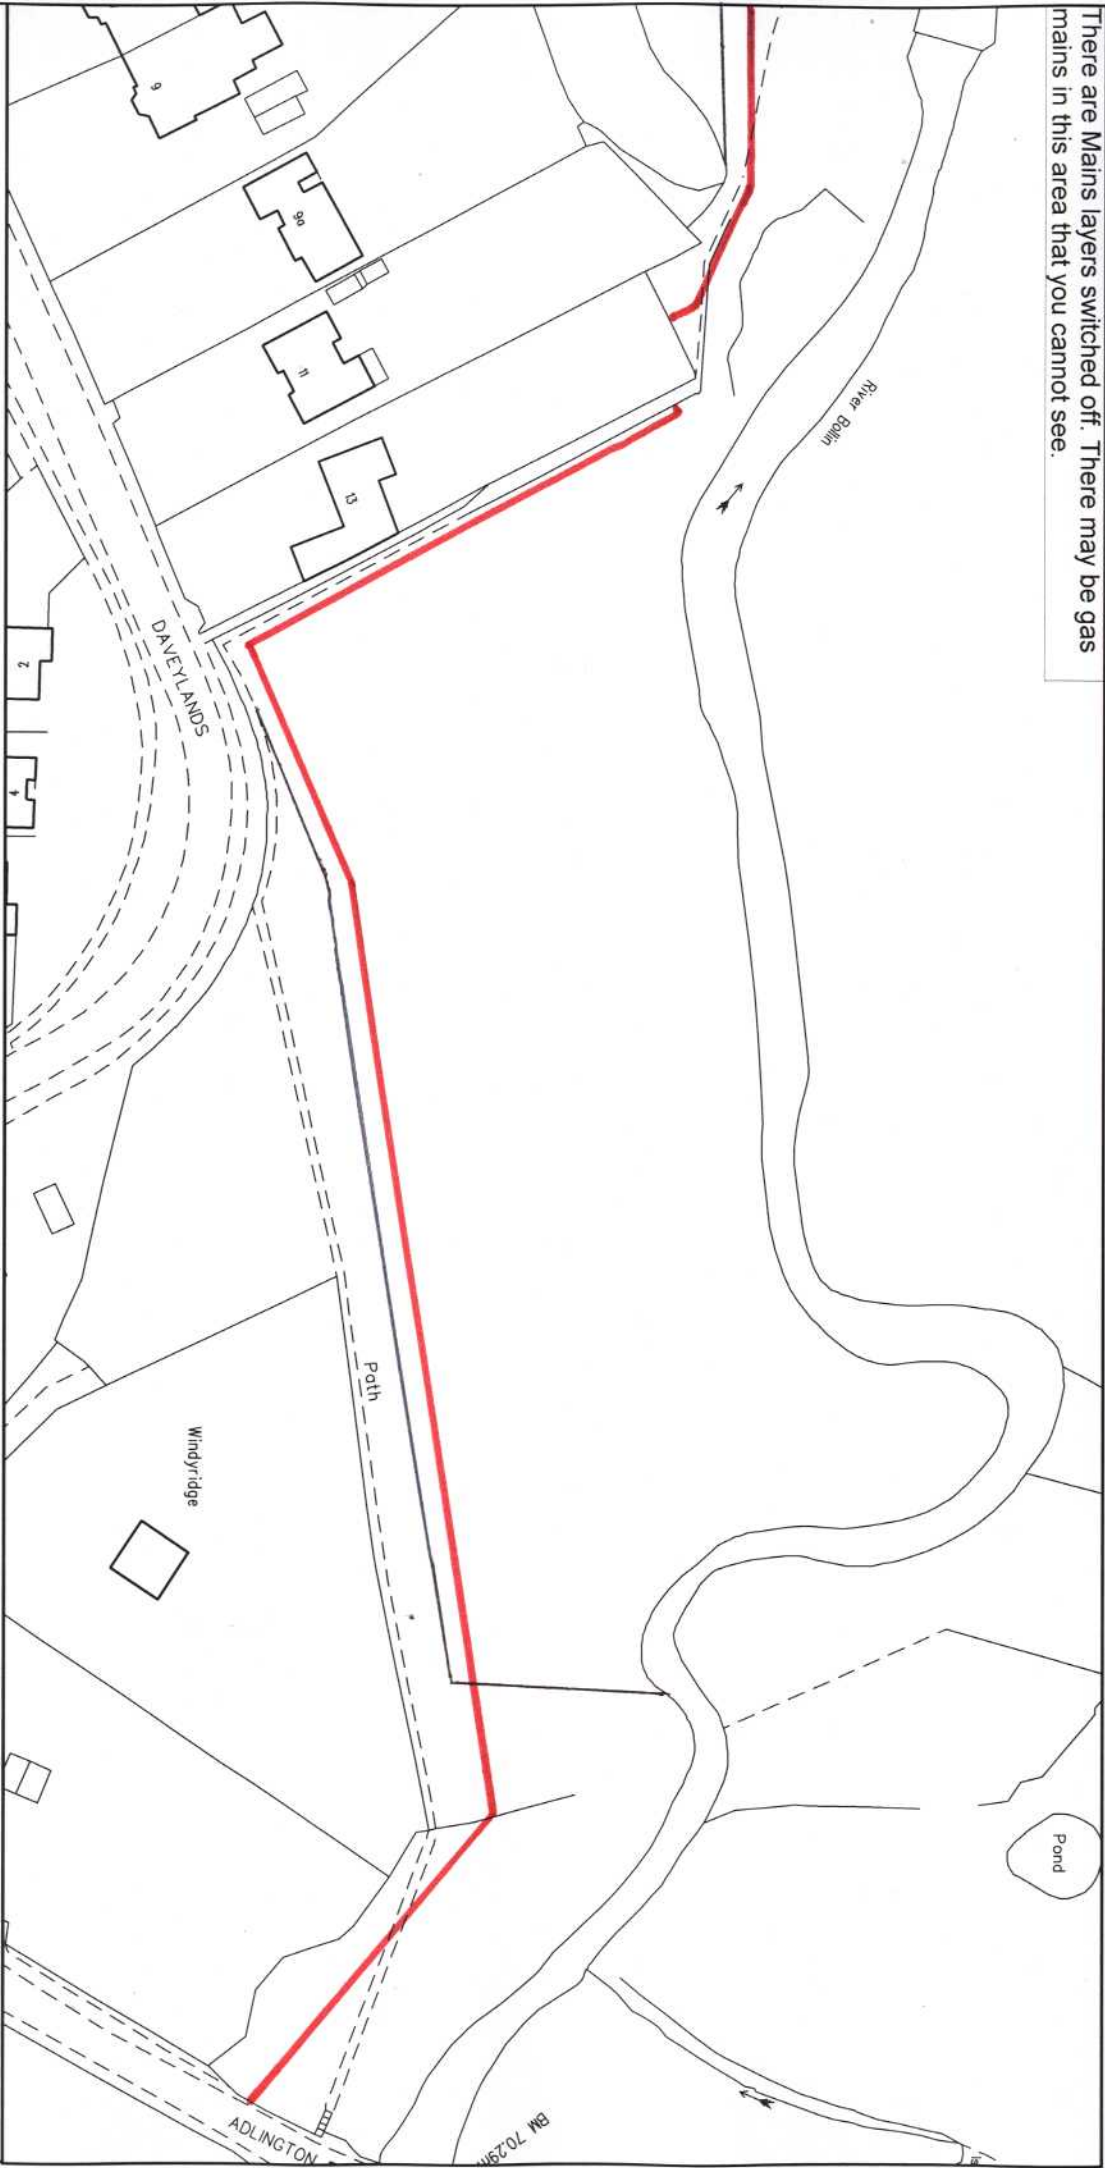

Warning: ALL AS-LAID MAINS LAYERS MAY NOT BE SHOWN

SCALE: Not to scale	LP MAINS
USER ID: james.dean	MP MAINS
DATE: 06/05/2010	IP MAINS
INTERNAL USE ONLY	LHP MAINS
MAP REF: S.18581	NHP MAINS
CENTRE: 385823, 381082	HISTORY MAINS
	LTs
	GTs
	SSSIs

This plan shows those pipes owned by National Grid Gas plc in their role as a Licensed Gas Transporter (GT). Gas pipes owned by other GTs, or otherwise privately owned, may be present in this area. Information with regard to such pipes should be obtained from the relevant owners. The information shown on this plan is given without warranty, the accuracy thereof cannot be guaranteed. Service pipes, valves, syphons, stub connections, etc. are not shown but their presence should be anticipated. No liability of any kind whatsoever is accepted by National Grid Gas plc or their agents, servants or contractors for any error or omission. Safe digging practices, in accordance with HSG47, must be used to verify and establish the actual position of mains, pipes, services and other apparatus on site before any mechanical plant is used. It is your responsibility to ensure that this information is provided to all persons (either direct labour or contractors) working for you on or near gas apparatus. The information included on this plan should not be referred to beyond a period of 28 days from the date of issue.

Some examples of Plant Items:

Valve	Depth of Cover	Syphon	Diameter Change	Material Change

Desktop MAPS Version 5.1.2.0	Hinckley Server
This plan is reproduced from or based on the OS map by National Grid Gas plc, with the sanction of the controller of HM Stationery Office. Crown Copyright Reserved.	